


Charles D. Flayhan Associates Inc.
New Corporate Bond
105th Floor

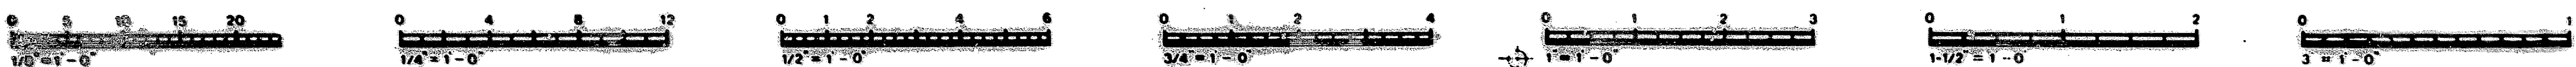

IF THIS DRAWING IS NOT 24" x 36" IT IS
A REDUCED PRINT, SCALE ACCORDINGLY

CABINETWORK SCHEDULE																		CABINET FINISHES		CABINET HARDWARE	
FLOOR	C/W NO	DESCRIPTION	LOCATION	ELEVATION		DETAIL		FINISH				HARDWARE				REMARKS	FURNISH & INSTALL BY	F-1	H-1		
				ELEV NO	DWG NO	DET NO	DWG NO	EXTR	INTR	TOP	FILLER	LOCK	HINGE	PULL	CATCH					DRAWER SLIDES	MISC.
105TH FLOOR	1	TRADING TABLE	SPACE NO. 4	2, 2A, 3, 5	9	1, 2, 3, 4, 5, 6, 7, 11, 12	10	F-1	F-2	F-1	-	H-3	-	-	-	H-4	H-1, H-2				
	2	TRADING TABLE	SPACE NO. 4	1, 1A, 3, 4	9	1, 2, 3, 4, 5, 6, 7, 11, 12	10	F-1	F-2	F-1	-	H-3	-	-	-	H-4	H-1, H-2				
	3	WALL MOUNTED CRT MONITOR SHELF	SPACE NO. 4	4	9	5, 6	8	F-1	M	+	F-1	-	-	-	-	-	-				
	4	CRT. SHELVES	SPACE NO. 5	1	8	3	8	F-1	-	-	F-4	-	-	-	-	-	-				
			</																		



CHARLES D. FLAYHAN ASSOCIATES INC.
880 CANAL STREET STAMFORD, CT. 06902
203 348-4300

DATE	ISSUED TO	PR.	TR.
12-7-84	POST AUTHORITY FOR APPROVAL CIVILS CORP. FOR BIDS C.F.C. FOR RECORD	10	1
1-18-85	POST AUTHORITY FOR APPROVAL CIVILS CORP. FOR INFORMATION C.F.C. FOR RECORD	10	1
5-9-85	POST AUTHORITY "AS BUILT"	0	2

AS-BUILT DRAWING
DATE: 5/2/96
INSPECTOR: [Signature]

NO.	DATE	REVISION	BY
1	4-24-85	OMITTED ITEM NO. 3 DETAILS NO. 4, 5, 6	JFP



CANTOR, FITZGERALD
SECURITIES CORP.
105th FLOOR
ONE WORLD TRADE CENTER, NEW YORK, N.Y.

NEW CORPORATE BOND
TRADING ROOM
CABINETWORK SCHEDULE
& MISC. DETAILS

NORTH	PROJECT NO. 1357A
	SCALE AS NOTED
	DRAWN BY J.F.P.
	CHECKED BY DATE: 12-6-84

DRAWING NO.
105F 8

PHASE
F
TAA NO. 3104
AS-BUILT DWG.
5-1-85

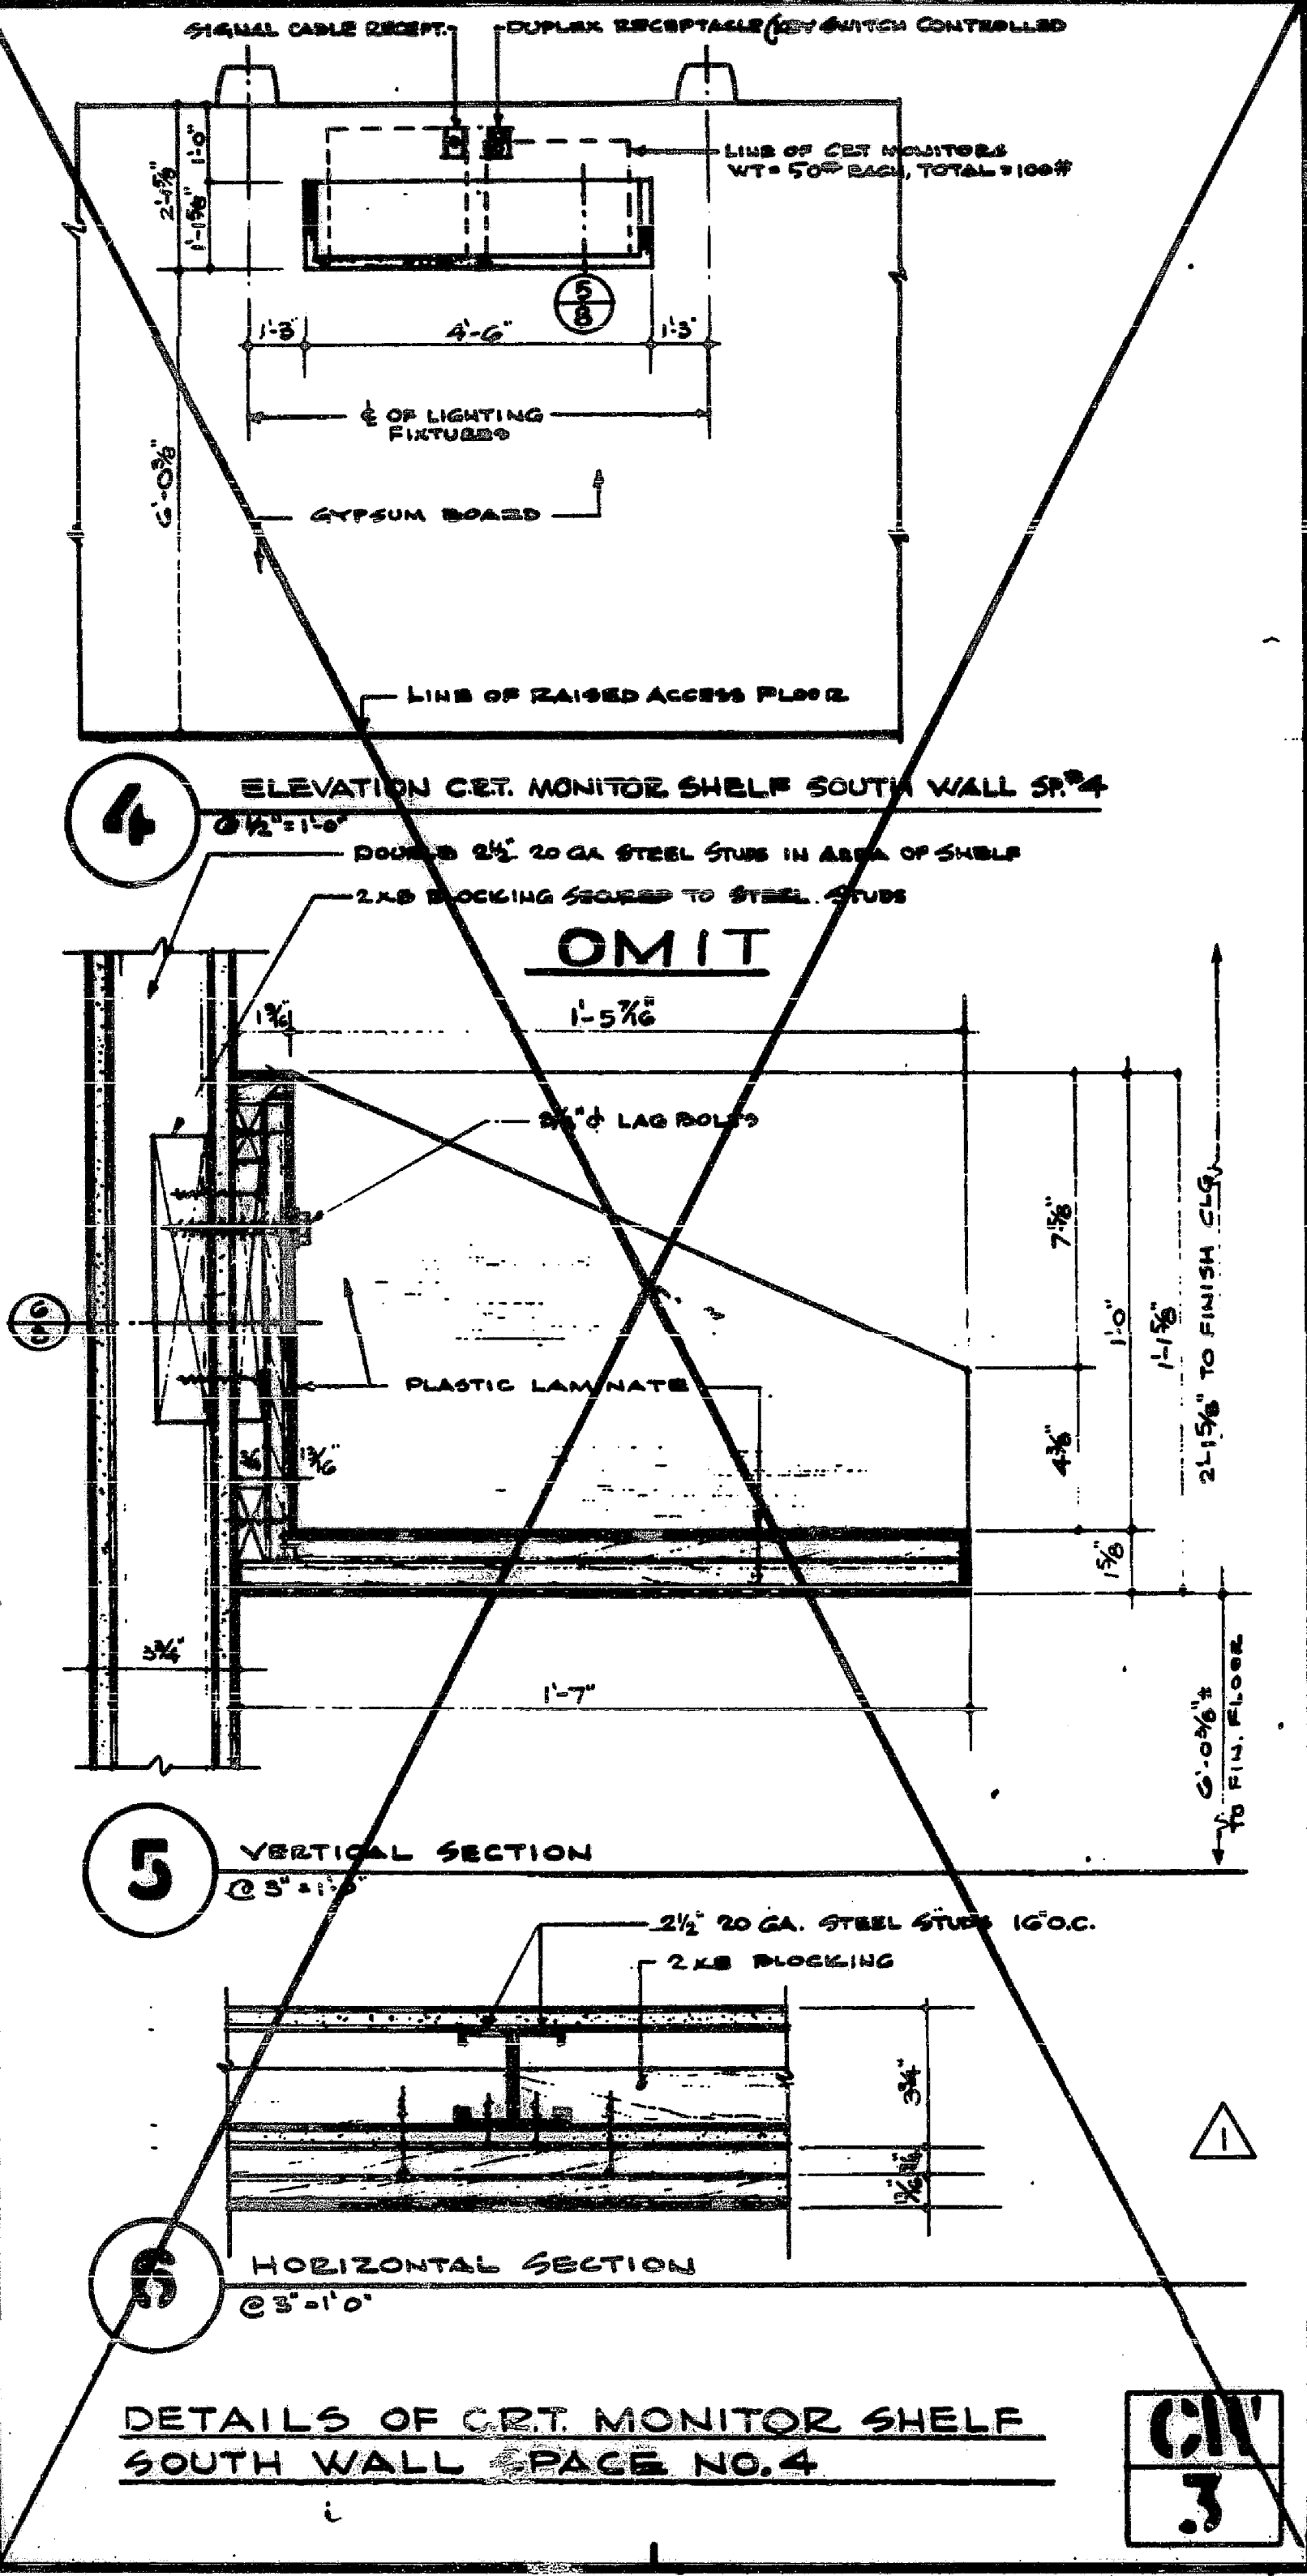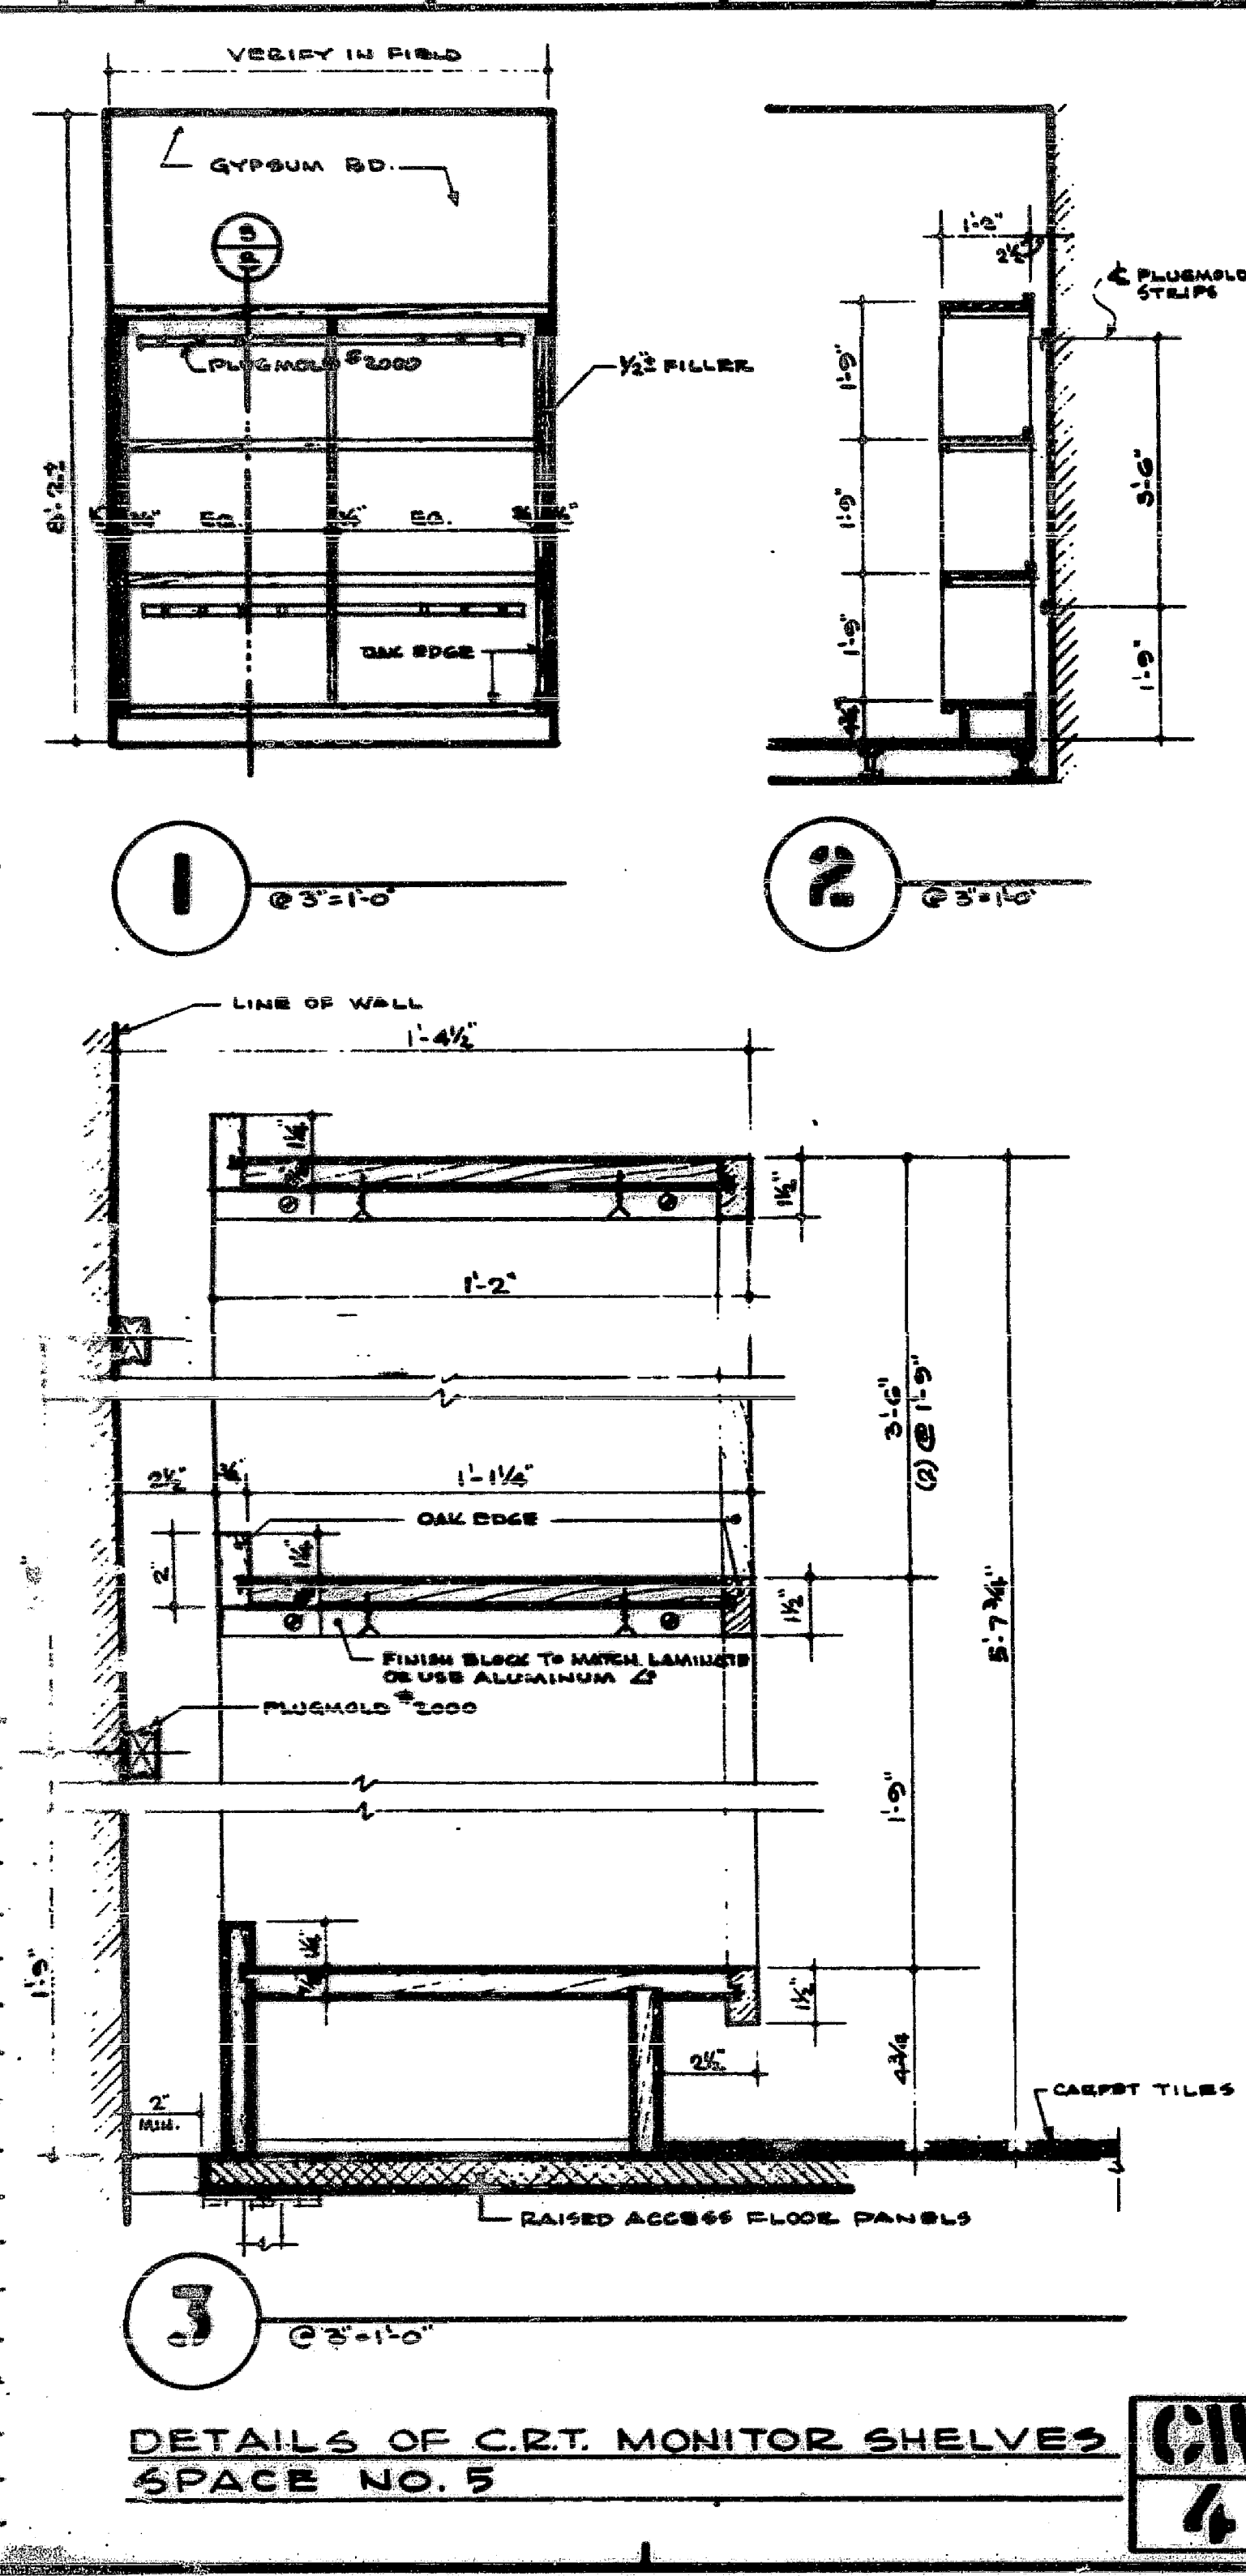

REVISION NUMBER
REVISION NUMBER
REVISION NUMBER